
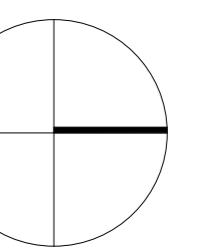


The information contained in this document is copyright and may not be used or reproduced for any other project or purpose. Verify all dimensions and levels on site and report any discrepancies to Strutt Studios for direction prior to the commencement of construction. Drawings are to be read in conjunction with all other contract documents. Use figured dimensions only. Do not scale from drawings. Strutt Studios cannot guarantee the accuracy of content and format for copies of drawings issued electronically. The completion of the Issue Details Checked and Authorised section below is confirmation of the status of the drawing. The drawing shall not be used for construction unless endorsed 'For Construction' and authorised for issue.

OUTSIDE OF SCOPE OF WORKS

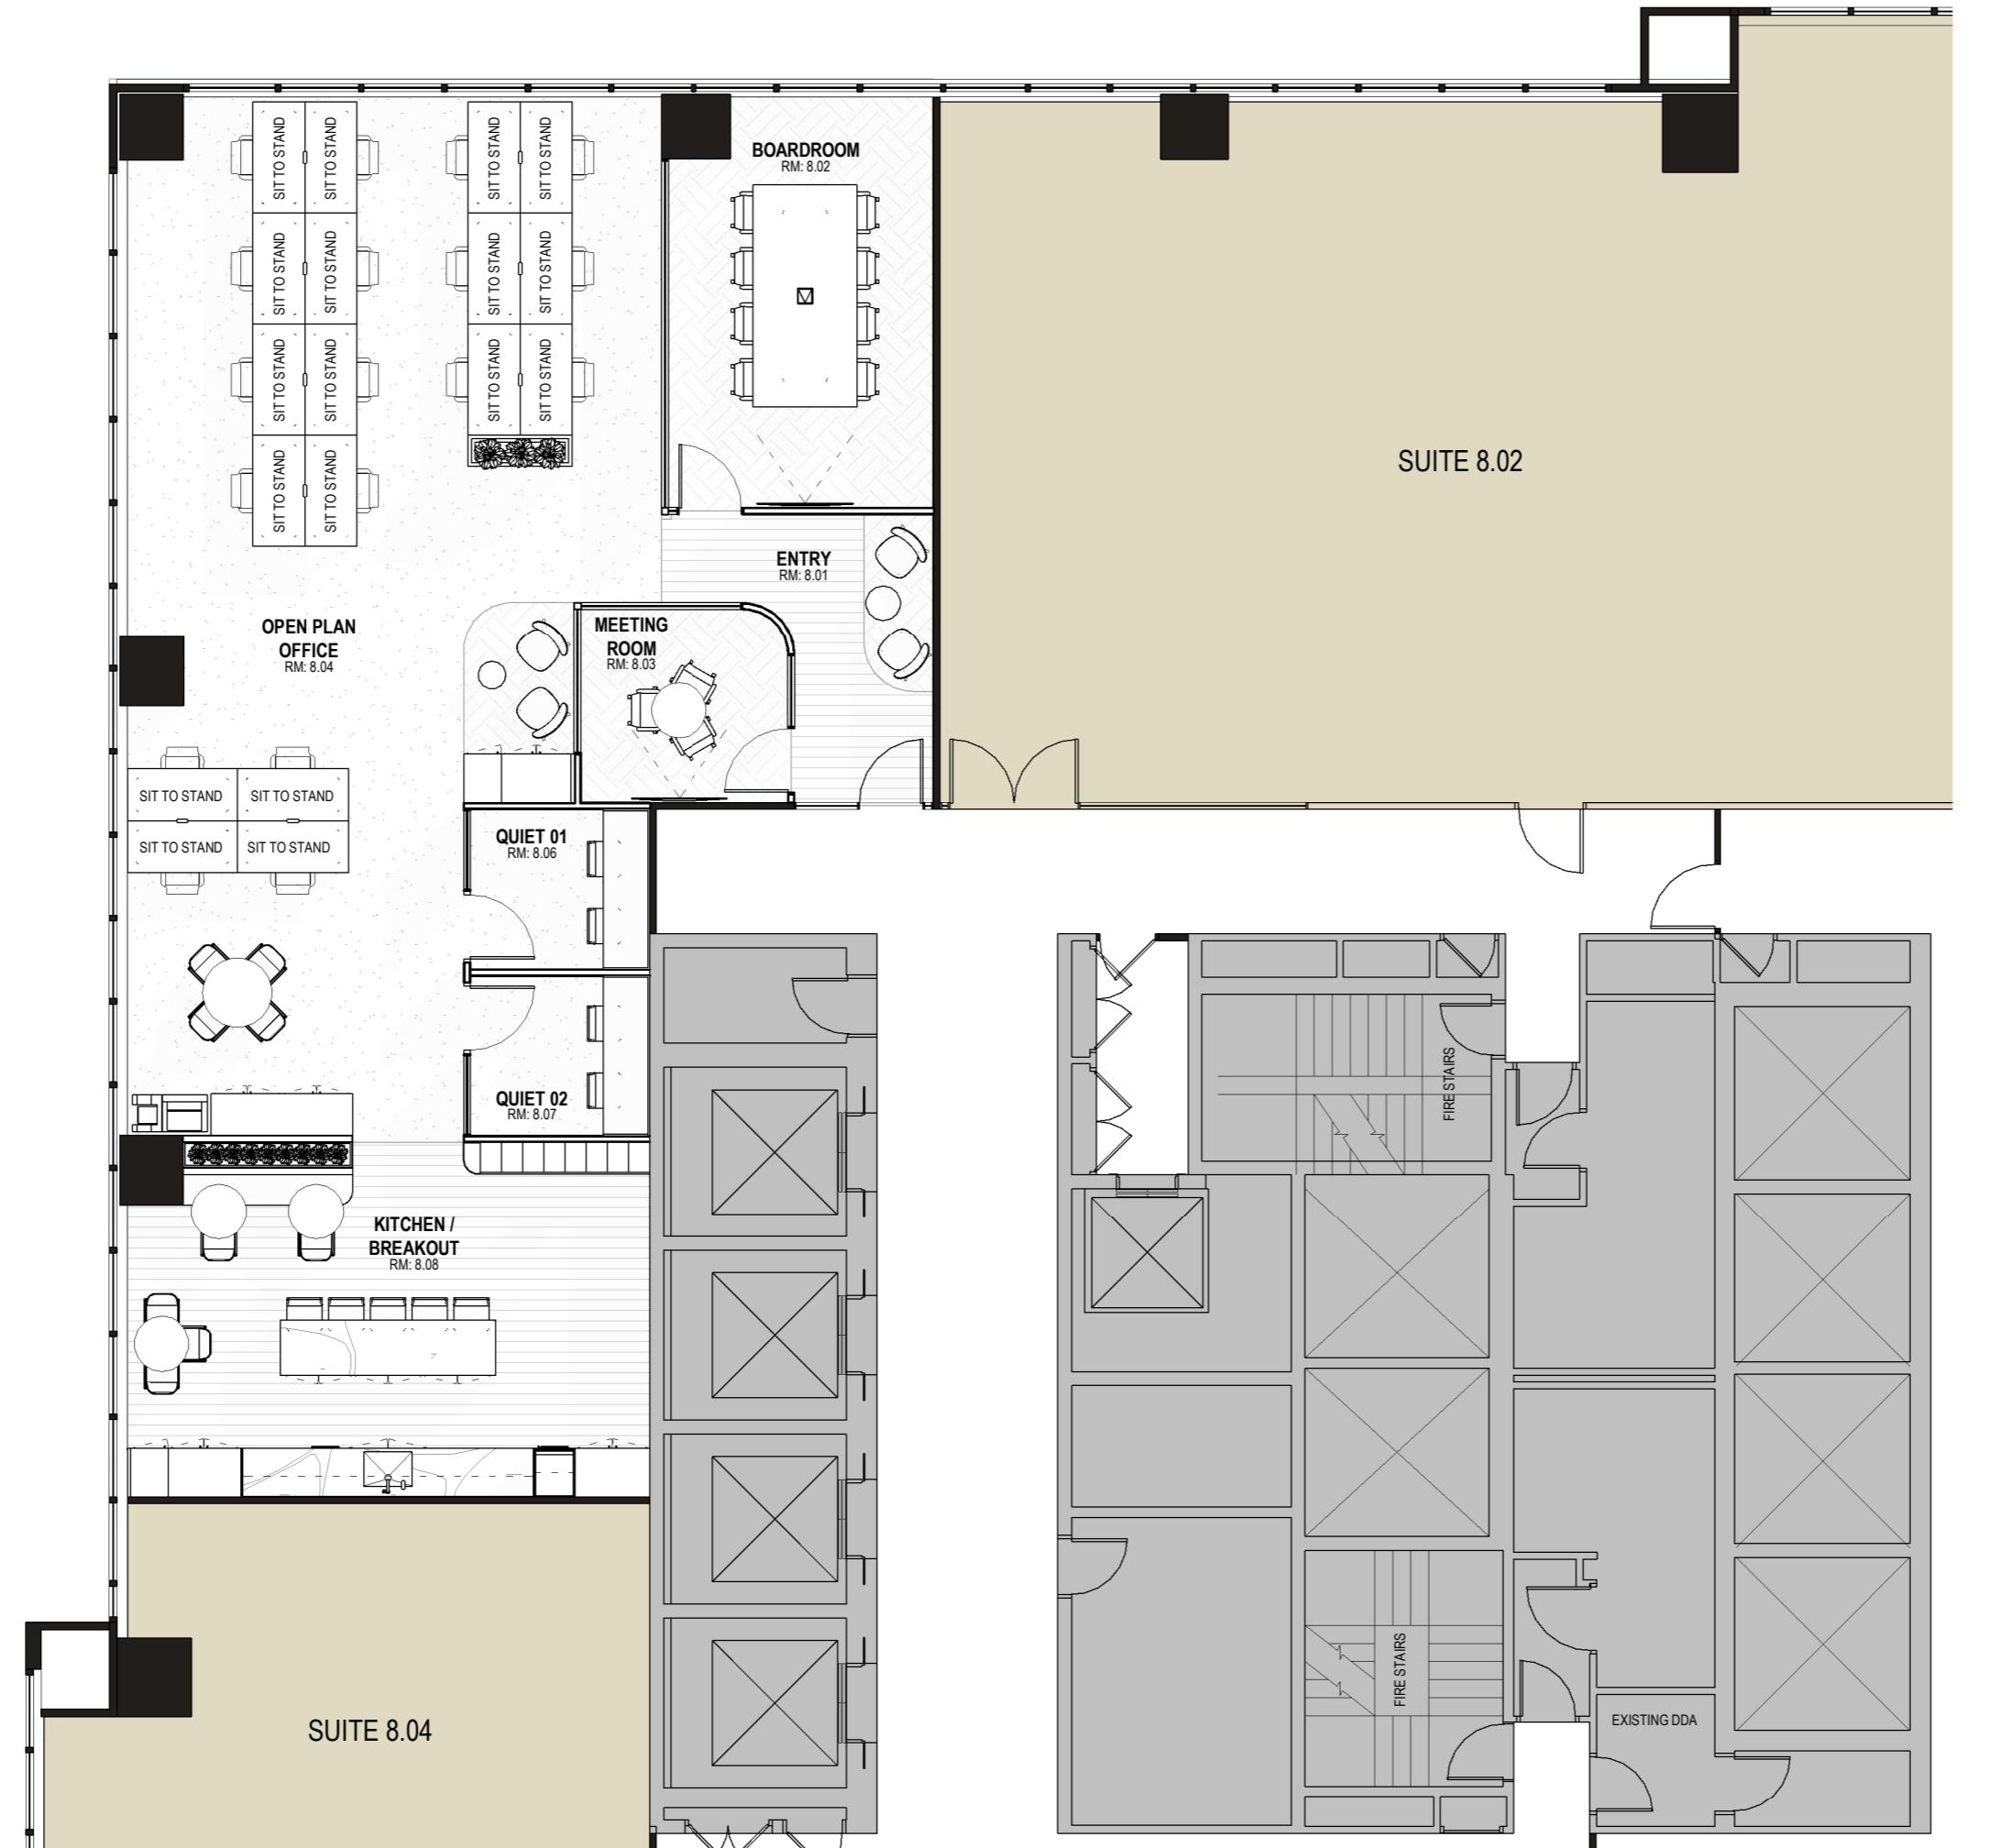

PROJECT MANAGER:
Forge.
Venture Management

BUILDER:
SCOPE
PROJECTS

STRUTT STUDIOS
INTERIOR
SYD AU

Suite 7, 17 Thurlow Street, Redfern NSW 2016
www.struttstudios.com

AS BUILT
FOR CONSTRUCTION ONLY
BASED ON INFORMATION PROVIDED

Revisions

Issue	Description	Date	Drw	Chk
-------	-------------	------	-----	-----

CLIENT

investa

LEVEL 8, 1 MARKET STREET, SYDNEY, NSW 2000

Scale	Project Area	Start-Up Date
-------	--------------	---------------

1:100 @ A2 201m² 14.06.2023

Project

SS23022
SUITE 8.01 - 1 MARKET ST

Drawing

LEVEL 8 - FLOOR PLAN

Drawing No.

A090