

SUITE 402 FLOOR PLAN  
80 MOUNT STREET

REV	DATE	DESCRIPTION
A	30.09.21	AS-BUILT FLOOR PLAN

BY	CLIENT
AG	X COMMERCIAL LEVEL 7, 10 HELP STREET CHATSWOOD
	PROJECT ADDRESS 80 MOUNT STREET NORTH SYDNEY

**X COMMERCIAL PTY LTD**  
A LEVEL 7, 10 HELP STREET  
CHATSWOOD, NSW 2067  
[XCOMMERCIAL.COM.AU](http://XCOMMERCIAL.COM.AU)





PROJECT  
**EXISTING FLOORPLAN**  
NORTH SYDNEY

Use figured dimensions only. Verify all levels and dimensions on site before commencing construction, fabrication, or shop drawings.  
© Copyright - All rights reserved.

DRAWN	DRAWING TITLE
	FLOORPLAN

CHECKED	SCALE @A3	JOB NUMBER
AG	1:100	
APPROVED	DRAWING NO.	REV
AG	101	A

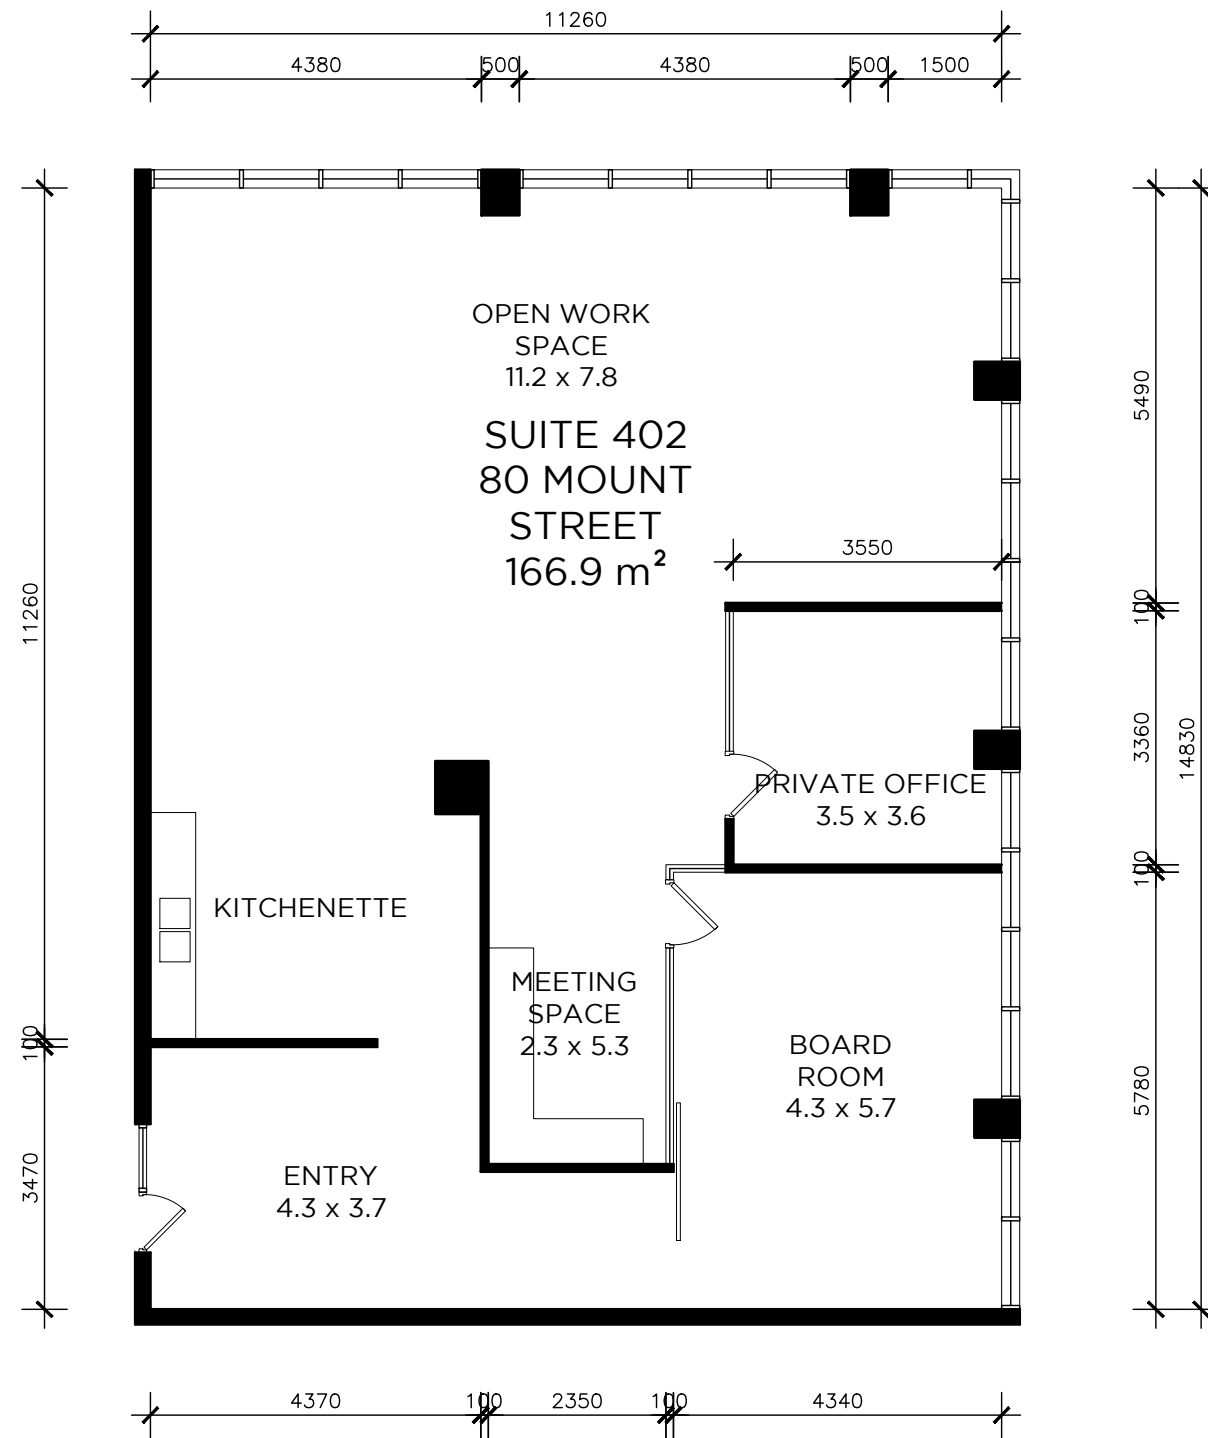

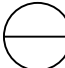
**SUITE 402 FLOOR PLAN**  
**80 MOUNT STREET**

REV	DATE	DESCRIPTION
A	30.09.21	AS-BUILT FLOOR PLAN

BY	CLIENT
AG	X COMMERCIAL LEVEL 7, 10 HELP STREET CHATSWOOD
	PROJECT ADDRESS 80 MOUNT STREET NORTH SYDNEY

**X COMMERCIAL PTY LTD**  
 A LEVEL 7, 10 HELP STREET  
 CHATSWOOD, NSW 2067  
[XCOMMERCIAL.COM.AU](http://XCOMMERCIAL.COM.AU)



PROJECT  
**EXISTING FLOORPLAN**  
**NORTH SYDNEY**

Use figured dimensions only. Verify all levels and dimensions on site before commencing construction, fabrication, or shop drawings.  
 © Copyright - All rights reserved.

DRAWN	DRAWING TITLE	JOB NUMBER
	FLOORPLAN - NO FURNITURE	
CHECKED	SCALE @A3	
	1:100	
APPROVED	DRAWING NO.	REV
AG	102	A